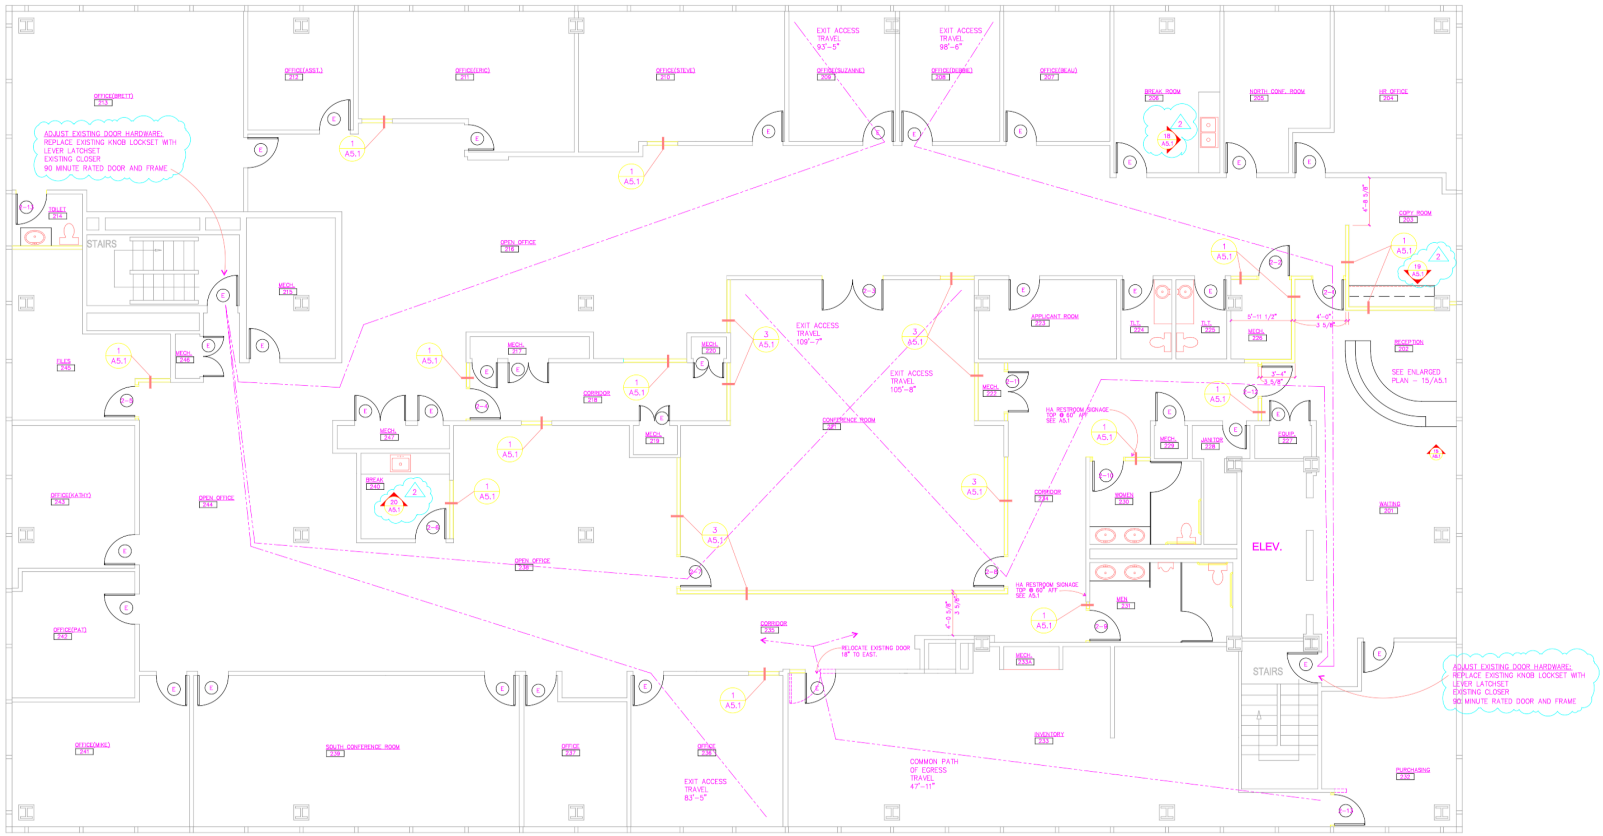

2ND FLOOR PLAN – NEW WORK
SCALE: 1/4"=1'-0"

SINGLE TENANT ONLY THIS FLOOR

General Notes

Seal

No.	Revision/Issue	Date
1	PLAN REVIEW	1/24
2	PLAN REVIEW	2/5

Firm Name and Address
JSM
Development Services, LLC
509 S. FIFTH STREET
CHAMPAIGN, ILLINOIS 61820
(217) 359-6838 (217) 359-6839 -FAX

Project Name and Address
RMR
VENTURES, LLC
OFFICE INTERIOR RENOVATIONS
201 W. UNIVERSITY
CHAMPAIGN, IL

Project: 08-35
Date: 12/11/08
Scale: AS SHOWN
Sheet: A3.3

AUTODESK Viewer
AUTODESK